


Al Aflaj-Site 01 _ Al seeh farm

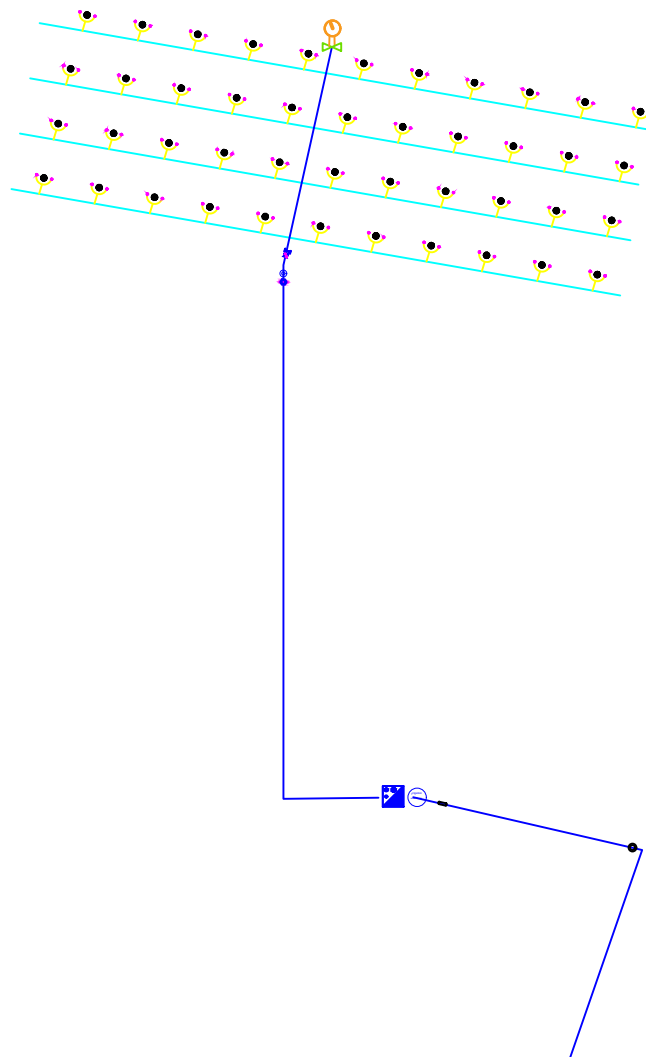

LEGEND

	HDPE PIPES 63mm @6 bar		Manual Valve 4 "		Control unit
	HDPE PIPES 32mm @6 bar		Filter Disk 2"		Manual Valve
			Isolation Valve		

Project Vision

The system requested here refers to a fully compatible smart date to the recent sustainable innovative and efficient irrigation system; which includes an Energy and pump unit using a solar energy system, a Control head including needed filtration systems, including all piping, fittings, valves, and gauges, Automatic Self-Cleaning Water Filter, Mainline and sub-line pipes, including valves, fittings back flow presenter, pressure regulators, Pipes from a plastic UV material to resist heatradiation

CONSULTANT :



Food and Agriculture Organization

CONTRACTOR :



AGRICULTURAL COOPERATIVE IN BULJURASHI

PROJECT TITLE :

MODERNIZATION OF IRRIGATION NETWORK

SHEET CONTENT :

AS built Drawing

Al Aflaj - Al seeh Farm

DRAWING NO.	01/02	
REVISIONS	APPROVED	
SCALE	FIT	
DATE : 11/08/2025		
COORDINATION	22°12'40.9"N 46°46'18.5"E	
SIGNATURE	NAME	PROFESSION
	Abdelmonem Hebesh	Irrigation Engineer

APPROVED BY:

Projects Manger **Mohamed Gamal Zaki**

AGRICULTURAL
COOPERATIVE IN BULJURASHI
STAMP

